

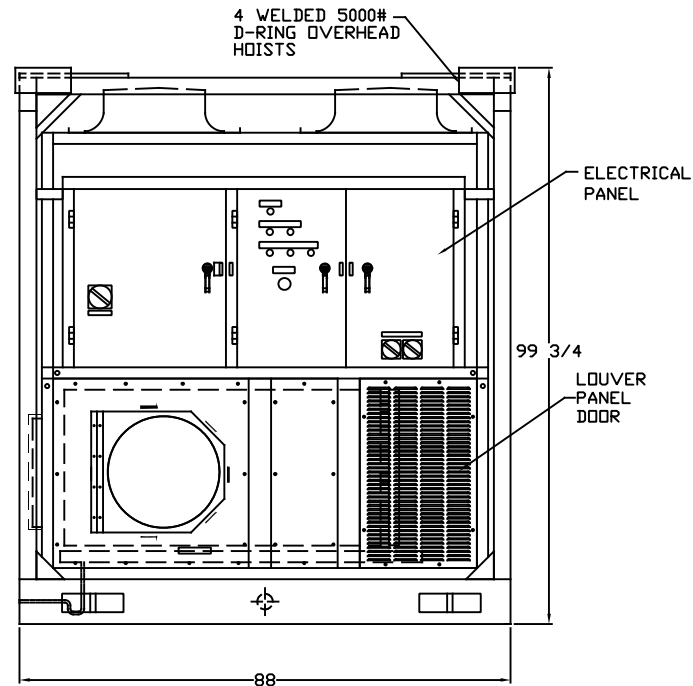


PLAN VIEW OF EVAP. BLOWER SECTION ONLY

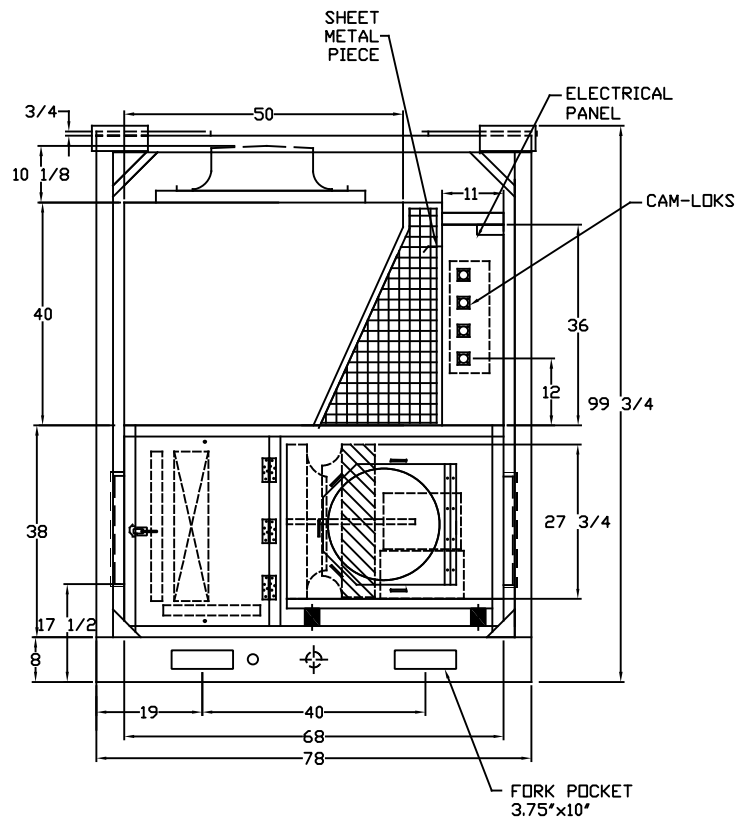

CERTIFIED DRAWING

POWER SUPPLY: 460/3/60HZ
FILTER ARRANGEMENT :

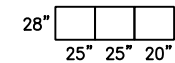

ALL DIMENSIONS ARE IN INCHES UNLESS OTHERWISE SPECIFIED.

DRAWN BY	AZRUL	DATE	03/10/2017
CHECKED BY	DJ	DATE	05/10/2017
APPROVED BY	SP	DATE	05/10/2017

01. AS BUILT

REV	DESCRIPTION	DATE	REV BY	CHK'D BY	APP'D BY
-----	-------------	------	--------	----------	----------



THIS DOCUMENT IS THE PROPERTY OF SMARTCH AND SHOULD NOT BE DISCLOSED OR USED WITHOUT THE EXPRESSED CONSENT OF COMPANY

PROJECT 2018 SACP40 Model

F/O :

MODEL SACP 40A-HS

TITLE
AIR COOLED PACKAGED

DRAWING NO S110840231

A4	SCALE : N.T.S	SHEET	OF
----	---------------	-------	----