


CERTIFIED DRAWING

COMP. : CPR27067
 COND. COIL : 4Rx14FPI (4)
 EVAP. COIL : 6Rx12FPI (1)
 COND. FAN : BLW27018
 BLOWER : BLW27021
 POWER SUPPLY : 460/3/60

FILTER ARRANGEMENT :

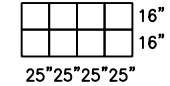

ALL DIMENSIONS ARE IN INCHES UNLESS OTHERWISE SPECIFIED.

DRAWN BY	AZRUL	DATE	28/02/2017
CHECKED BY	DJ	DATE	01/03/2017
APPROVED BY	SP	DATE	01/03/2017

01. AS BUILT.

REV	DESCRIPTION	DATE	REV BY	CHK'D BY	APP'D BY
-----	-------------	------	--------	----------	----------



THIS DOCUMENT IS THE PROPERTY OF SMARTECH AND SHOULD NOT BE DISCLOSED OR USED WITHOUT THE EXPRESSED CONSENT OF COMPANY

PROJECT

F/O :

MODEL SACP 80A-HS


TITLE

AIR COOLED PACKAGED

DRAWING NO S110840220

A4	SCALE : N.T.S	SHEET	OF
----	---------------	-------	----

SMT/MFG/ENG/FM/05-R1

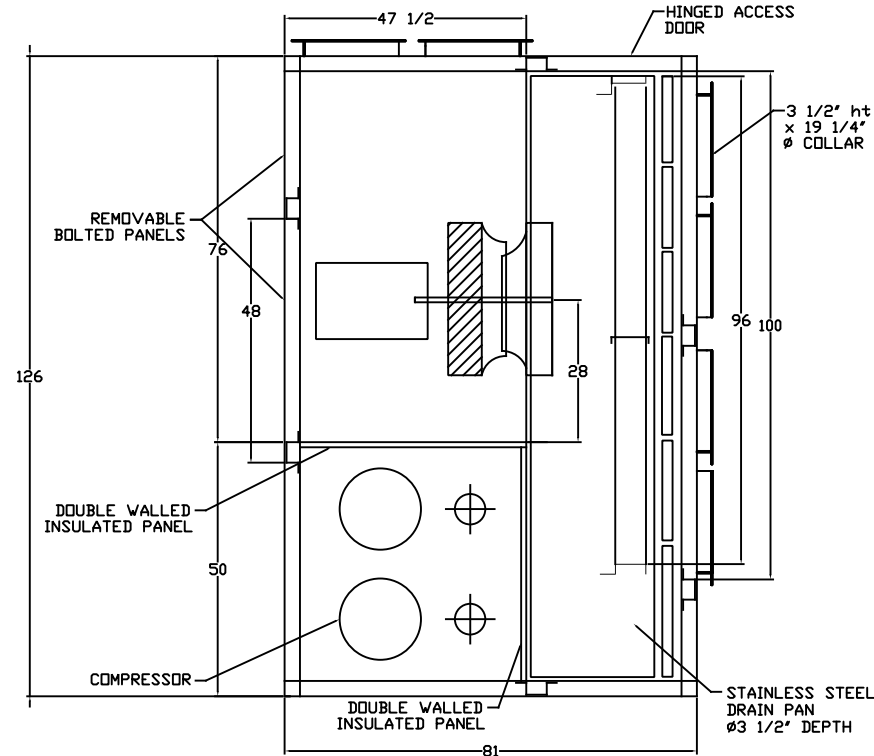

PLAN VIEW OF EVAP. BLOWER SECTION ONLY

